



1ST FLOOR

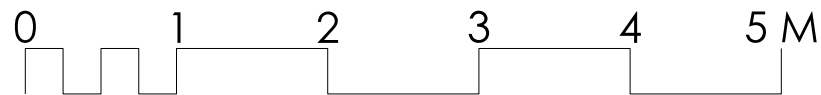

 JK Ltd CHARTERED ARCHITECTS 1. The Crescent, Barnes, London, SW13 0NN Tel: 020 88760206 Fax: 056 03412558				Project 121A GODOLPHIN ROAD LONDON W12 8JN	Date 10 Mar. 14 Scale 1:50 @A3	Revision —
	A <small>Revision</small>	00.00,00 <small>Date</small>	Null <small>Amendments</small>	Drawing Title FIRST FLOOR PLAN AS BUILT	Drawing No. 13-011 /101	